


ASBUILT DRAWING  
FOR  
**BAY BREEZE  
CONDOMINIUM**




SITUATED IN THE TOWNSHIP OF  
VERMILION, COUNTY OF ERIE,  
STATE OF OHIO

400  
167  
BANKET  
DRAIN

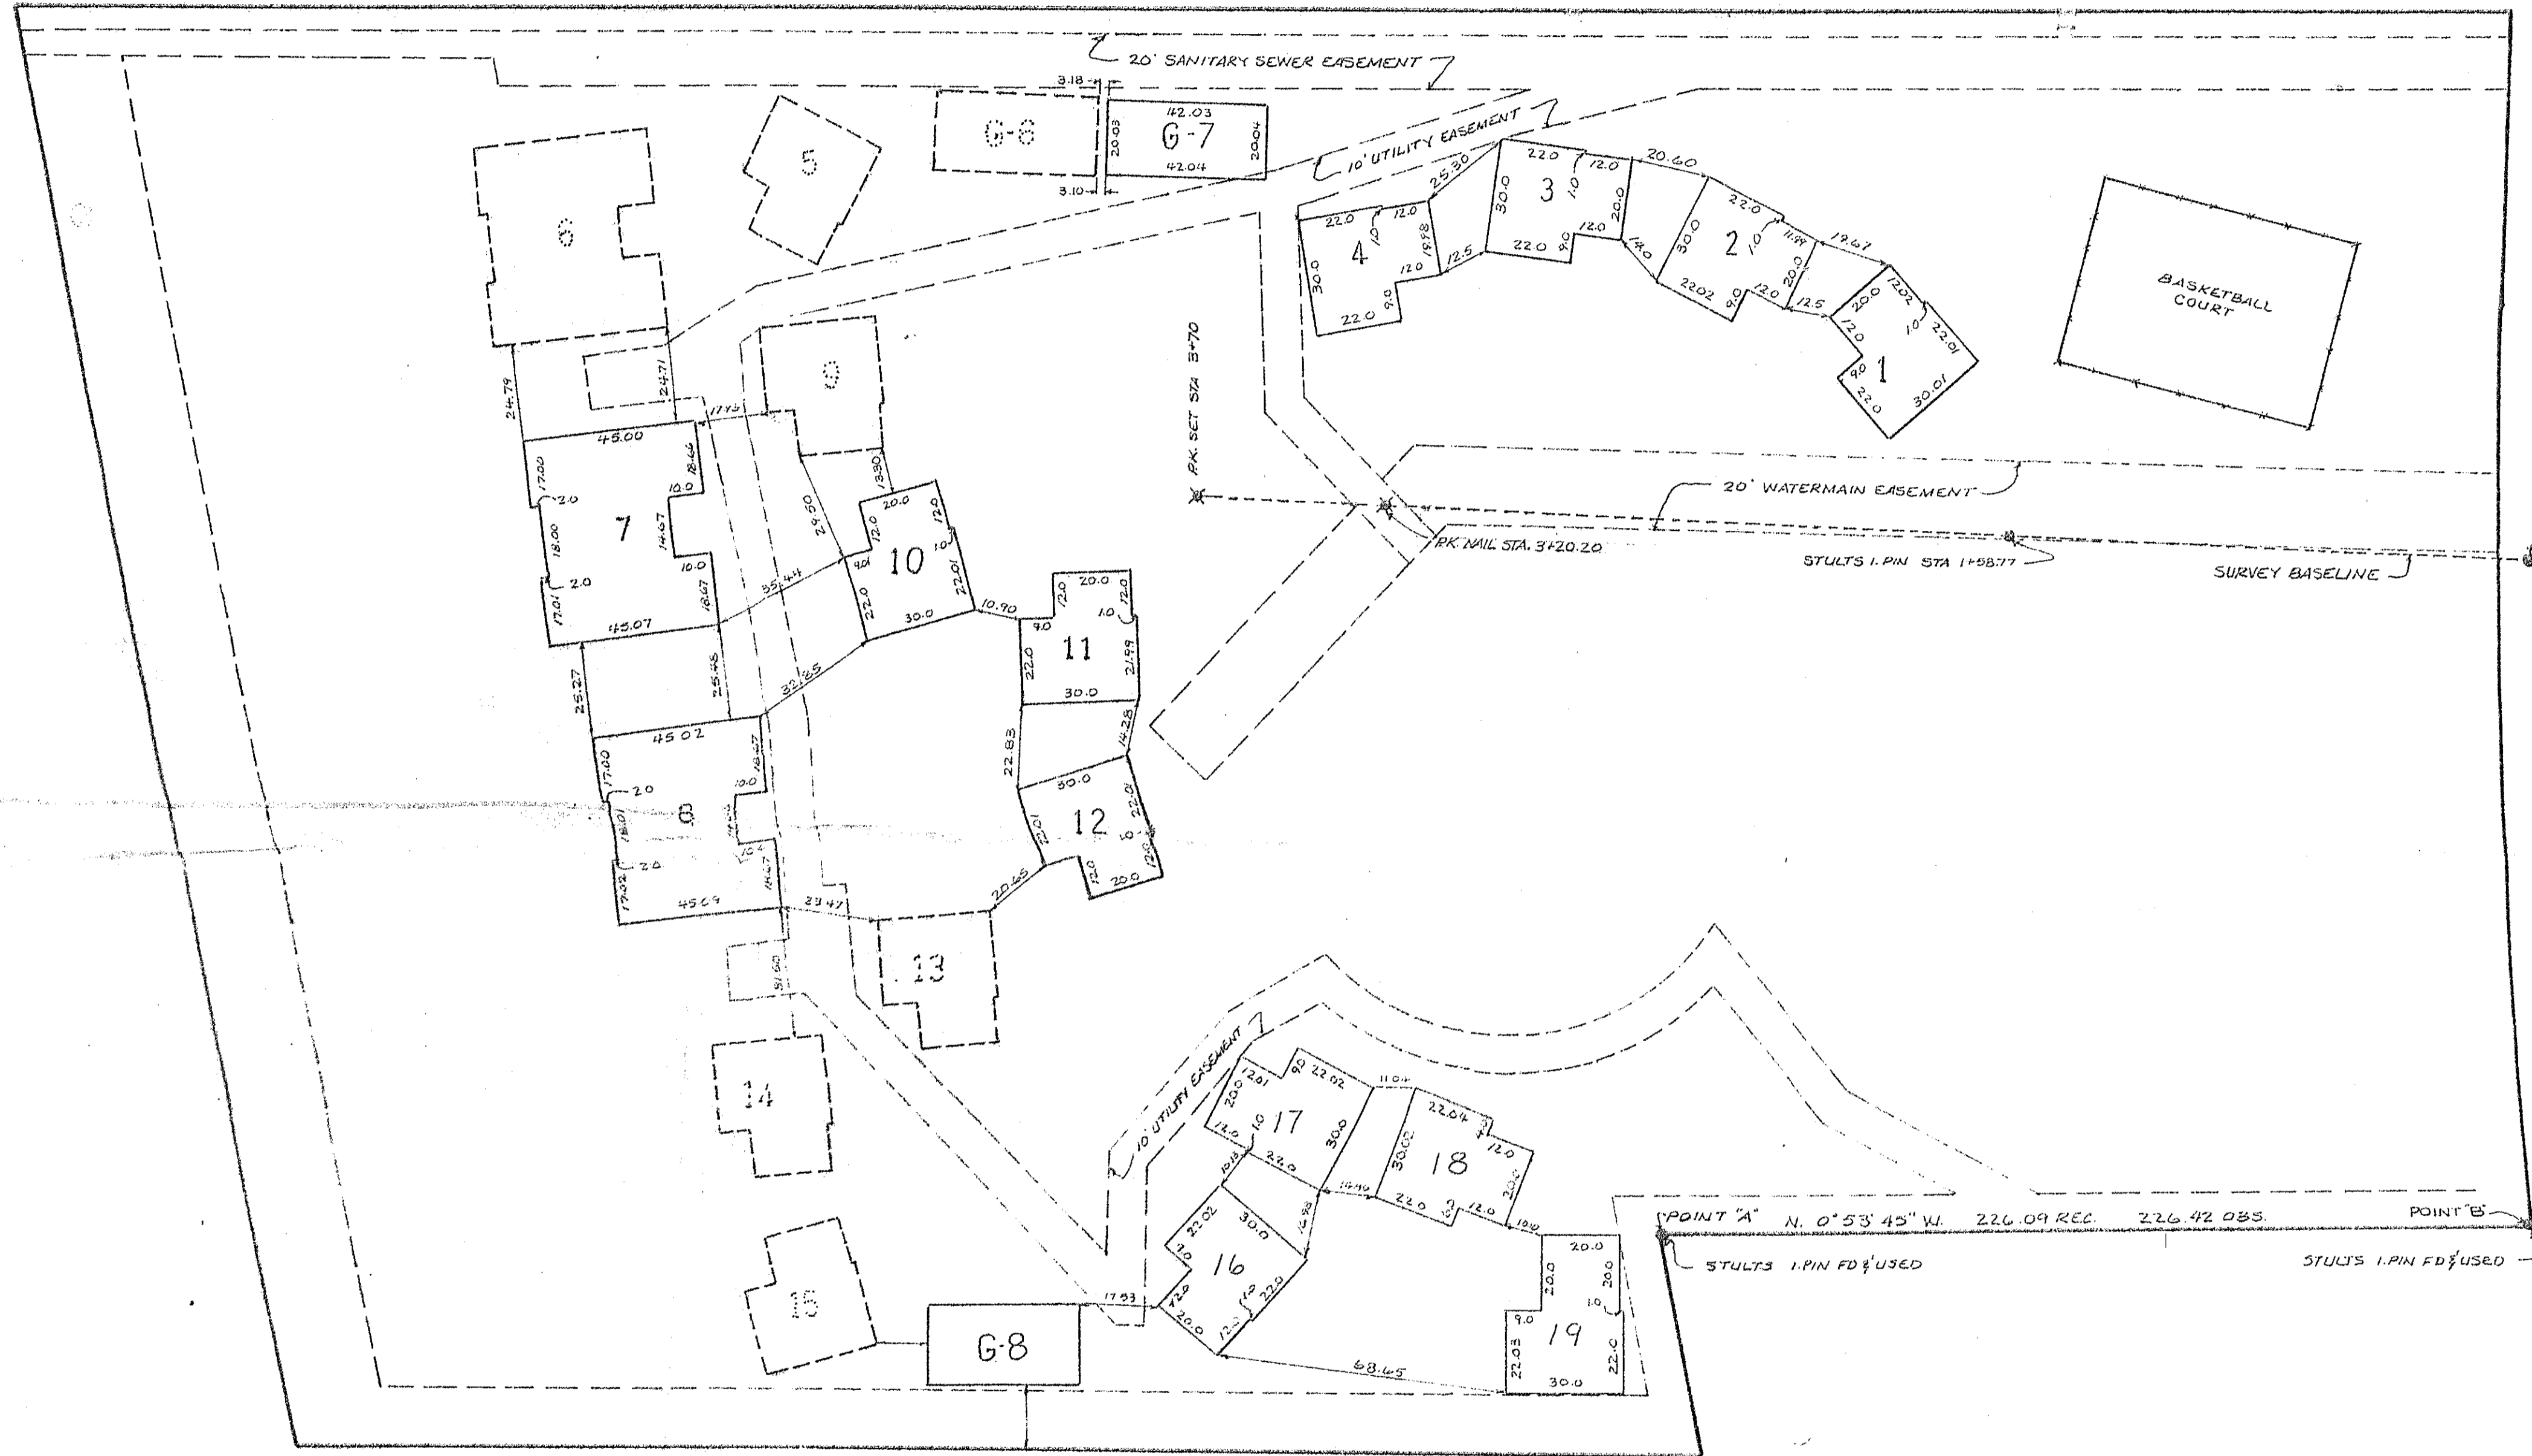

SCALE 1" = 30'  
OCTOBER 1996

LEGEND

-  EXTG. BLDGS.
-  IRON PINS FD.
-  R.K. NAILS SET